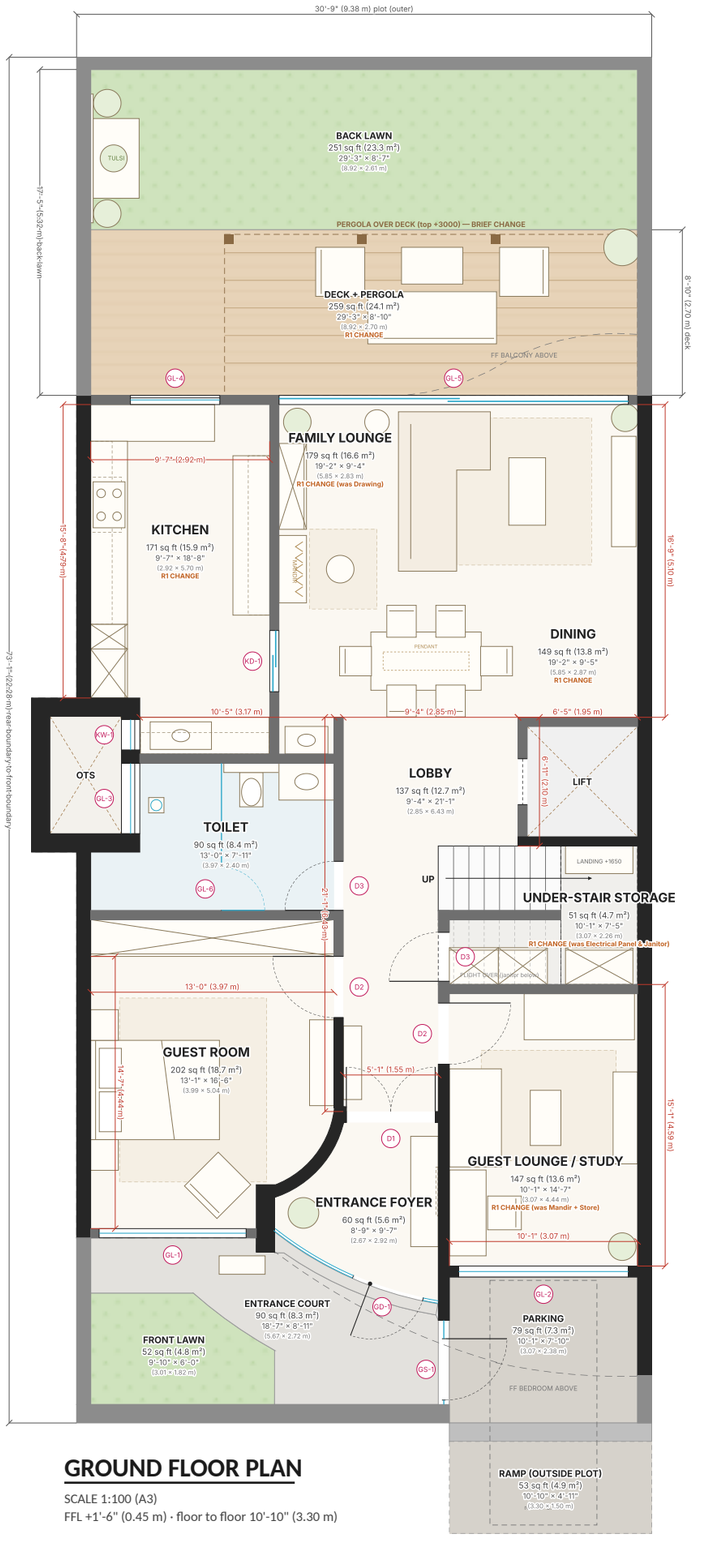
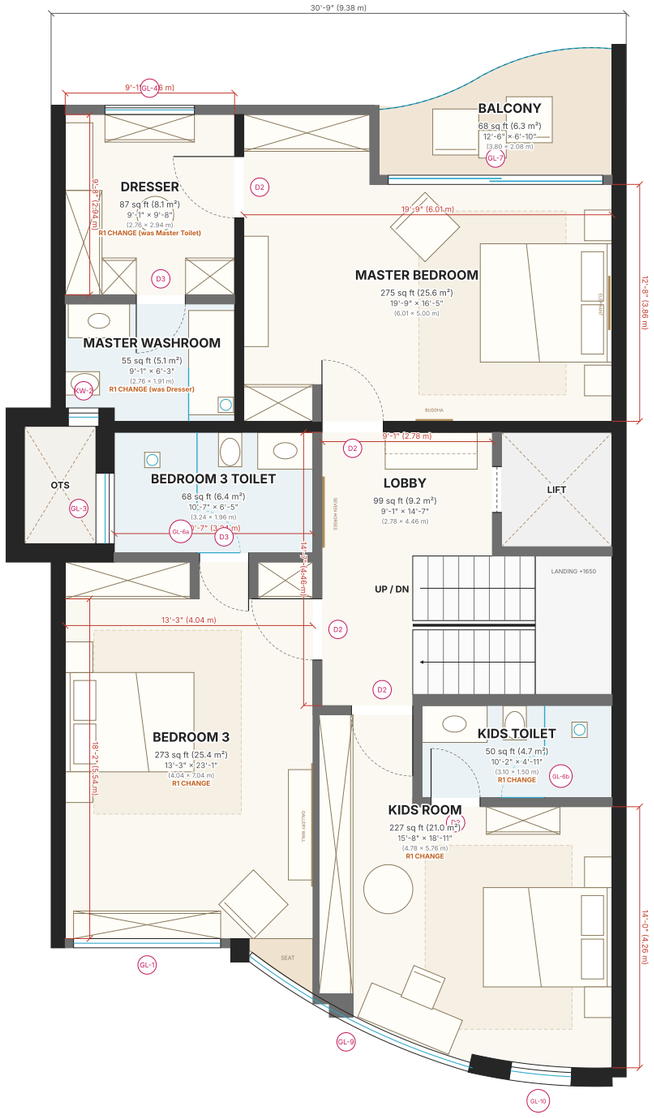



## GROUND FLOOR PLAN

SCALE 1:100 (A3)
FFL +1'-6" (0.45 m) · floor to floor 10'-10" (3.30 m)




## FIRST FLOOR PLAN

SCALE 1:100 (A3)
FFL +12'-4" (3.75 m) · floor to floor 10'-10" (3.30 m)

### LEGEND

- Existing wall
- Proposed wall (SF)
- Glass / glazing
- D2 — Door / window mark (see schedule)
- New wall / partition
- Boundary wall 1500 high
- Floor above / overhead (dashed)
- R1 CHANGE — room changed from R0

N
road side

### REVISIONS

| REV | DATE | DESCRIPTION |
|---|---|---|
| R0 | 17.08.25 | Ground floor plan issued for approval (UPS). |
| R1 | 26.10.26 | Owner changes of Oct 2026 on R0: layout, Vastu red-lines, plumbing, electrical and materials. FF and proposed SF added. See sheet 2. |

GRAPHIC SCALE 1:100
0 — 5 m
0 — 16 ft

## DOOR-WINDOW SCHEDULE

| MARK | SIZE | CILL | LINTEL | NOS | DESCRIPTION | LOCATION | R1 |
|---|---|---|---|---|---|---|---|
| GL-1 | 7'-10" × 7'-7" (2.40 × 2.30 m) | 0'-4" (0.10 m) | 7'-10" (2.40 m) | 2 | Glass Window Fixed/Openable | GF Guest Room; FF Bedroom 3 | |
| GL-2 | 9'-1" × 7'-7" (2.77 × 2.30 m) | 0'-4" (0.10 m) | 7'-10" (2.40 m) | 1 | Glass Window Fixed/Openable | GF Guest Lounge / Study | |
| GL-3 | 3'-9" × 4'-9" (1.15 × 1.45 m) | 3'-1" (0.95 m) | 7'-10" (2.40 m) | 2 | Glass Window Openable | GF Toilet; FF Bedroom 3 Toilet | |
| GL-4 | 4'-9" × 4'-9" (1.46 × 1.45 m) | 3'-1" (0.95 m) | 7'-10" (2.40 m) | 2 | Glass Window Openable | GF Kitchen; FF Dresser | |
| GL-5 | 18'-8" × 7'-7" (5.70 × 2.30 m) | 0'-4" (0.10 m) | 7'-10" (2.40 m) | 1 | Glass Door/Window Fixed/Openable | GF Family Lounge | |
| GL-6 | As per site (6'-7" / 2.00 m high) | 0'-4" (0.10 m) | — | 4 | Shower Partition with glass door | GF Toilet; FF Bedroom 3 Toilet, Kids Toilet, Master Washroom | |
| GL-7 | 11'-6" × 7'-7" (3.50 × 2.30 m) | 0'-4" (0.10 m) | 7'-10" (2.40 m) | 1 | Glass Door/Window Fixed/Openable | FF Master Bedroom | |
| GL-8 | 13'-0" × 3'-7" (3.98 × 1.10 m) | 0'-4" (0.10 m) | — | 1 | Glass Railing | FF Balcony | |
| GL-9 | 13'-5" × 7'-7" (4.10 × 2.30 m) | 0'-4" (0.10 m) | 7'-10" (2.40 m) | 1 | Glass Window Fixed/Openable | FF Kids Room | |
| GL-10 | 3'-3" × 4'-9" (1.00 × 1.45 m) | 3'-1" (0.95 m) | 7'-10" (2.40 m) | 1 | Glass Window Openable | FF Kids Room | |
| GL-F | 9'-8" arc (2.95 m) × full height | — | — | 1 | Curved frameless glass facade, floor to ceiling | GF Entrance Foyer | added |
| GD-1 | 3'-11" × 7'-10" (1.20 × 2.40 m) | — | 7'-10" (2.40 m) | 1 | Frameless glass pivot entry door (in GL-F) | GF Entrance Foyer | added |
| GS-1 | 3'-3" × 6'-11" (1.00 × 2.10 m) | — | 6'-11" (2.10 m) | 1 | Glass screen with 1000 gate | GF Parking / Entrance Court | added |
| KD-1 | 3'-3" × 7'-10" (1.00 × 2.40 m) | — | 7'-10" (2.40 m) | 1 | Sliding door, fluted glass in black frame | GF Dining / Kitchen | new |
| KW-1 | 1'-8" × 2'-0" (0.50 × 0.60 m) | 3'-5" (1.05 m) | 5'-5" (1.65 m) | 1 | Vent window with exhaust fan, into OTS | GF Kitchen | new |
| KW-2 | 1'-8" × 2'-0" (0.50 × 0.60 m) | 4'-11" (1.50 m) | 6'-11" (2.10 m) | 1 | Vent window with exhaust fan, into OTS | FF Master Washroom | new |
| D1 | 4'-9" × 7'-10" (1.45 × 2.40 m) | — | 7'-10" (2.40 m) | 1 | Flush Door, double leaf (main door) | GF Entrance Foyer | |
| D2 | 3'-3" × 7'-10" (1.00 × 2.40 m) | — | 7'-10" (2.40 m) | 6 | Flush Door | GF Guest Lounge / Study, Guest Room; FF Bedroom 3, Kids Room, Master Bedroom, Master Bedroom / Dresser | |
| D3 | 2'-7" × 7'-10" (0.80 × 2.40 m) | — | 7'-10" (2.40 m) | 5 | Flush Door | GF Toilet, Under-stair Storage; FF Bedroom 3 Toilet / Bedroom 3, Dresser / Master Washroom, Kids Toilet / Kids Room | |
| D4 | As Lift | — | — | 2 | As Lift, as per lift vendor | GF Lift / Lobby; FF Lift / Lobby | |

Sizes W × H in feet-inches (metres). CILL and LINTEL above finished floor. NOS = number on this sheet. new = not on R0; added = drawn on R0, not scheduled. ± = more than one size, as marked on plan.

## FINISHING SCHEDULE

| LOCATION | FLOOR | WALL | CEILING | REMARKS | R1 |
|---|---|---|---|---|---|
| GF Parking & Ramp | Cobble Stone | Granite Stone | — | | |
| GF Entrance Court | Granite Stone (flamed) | Paint Finish | Paint Finish | | |
| GF Entrance Foyer | Italian Stone* | Veneer Cladding; fluted veneer feature wall | POP Painted / Veneer, cove light | | △ |
| GF Lobby | Italian Stone* | Veneer Cladding | POP Painted, cove light | | △ |
| GF Guest Lounge / Study | Italian Stone* | Veneer Cladding | POP Painted, cove light | was Mandir + Store. Desk, sofa, settee, TV (B5) | △ |
| GF Guest Room | Italian Stone* | Paint Finish | POP Painted, cove light | Wardrobe on S wall | |
| GF Toilet | Tile (matte 1200×600) | Tile | POP Painted | | |
| GF Family Lounge | Italian Stone* | Paint Finish; fluted veneer feature wall | POP Painted, cove light | was Drawing. TV + AC on W wall; open mandir in NE corner (B3, B6) | △ |
| GF Dining | Italian Stone* | Paint Finish | POP Painted, cove light + veneer raft | Dining beside the lobby; hand-wash basin niche (D-01, B3) | △ |
| GF Kitchen | Italian Stone* | Paint Finish; Italian Stone backsplash | POP Painted, cove light | Closed U-kitchen + wash nook; counter top black granite 20 mm (D-01, B4) | △ |
| GF Under-stair Storage | Granite Stone (flamed) | Paint Finish | Stair soffit, painted | was Electrical Panel & Janitor. Cupboards to stair soffit; inverter / network rack (B7) | + |
| GF Deck + Pergola | Deck tile (wood-look, anti-skid) | Paint Finish | Pergola, open | Deck + pergola; tulsi in lawn NE corner (B15) | △ |
| FF Master Washroom | Tile (matte 1200×600) | Tile | POP Painted | was Dresser. Tub + over-tub screen; WC on OTS stack; sunken floor (hold) (C10) | + |
| FF Dresser | Italian Stone* | Paint Finish | POP Painted, cove light | was Master Toilet. Walk-in dresser lit by GL-4; mirror on E wall (C10) | + |
| FF Master Bedroom | Italian Stone* | Paint Finish; fluted veneer feature wall | POP Painted, cove light | | + |
| FF Balcony | Deck tile (wood-look, anti-skid) | Paint Finish | — | | + |
| FF Bedroom 3 Toilet | Tile (matte 1200×600) | Tile | POP Painted | | + |
| FF Lobby | Italian Stone* | Paint Finish | POP Painted, cove light | Pantry counter by lift, black granite top (C8) | + |
| FF Bedroom 3 | Italian Stone* | Paint Finish | POP Painted, cove light | Front-left bedroom (D-04) | + |
| FF Kids Room | Italian Stone* | Paint Finish | POP Painted, cove light | Study desk along GL-9 (C9, D-04) | + |
| FF Kids Toilet | Tile (matte 1200×600) | Tile | POP Painted | Back at its R0 place, stack SS-3 (C9) | + |

* Italian Stone: Option A Italian marble 18 mm polished in place, or Option B large-format vitrified 1600 × 800 marble look. Owner to decide (materials schedule F16).
Tile: matte porcelain 1200 × 600, floors and walls of wet rooms. △ = changed from R0; + = row added in R1 (R0 schedules the GF only).


CONTRACTOR:-
UNIQUE PROJECT SOLUTIONS
D-53/4, Ground Floor, Shaheen Bagh, Abul Fazal Encl.-2
Jamia Nagar, Okhla, New Delhi 110025
E- uniqueprojectsolutions@gmail.com
M-9911012341

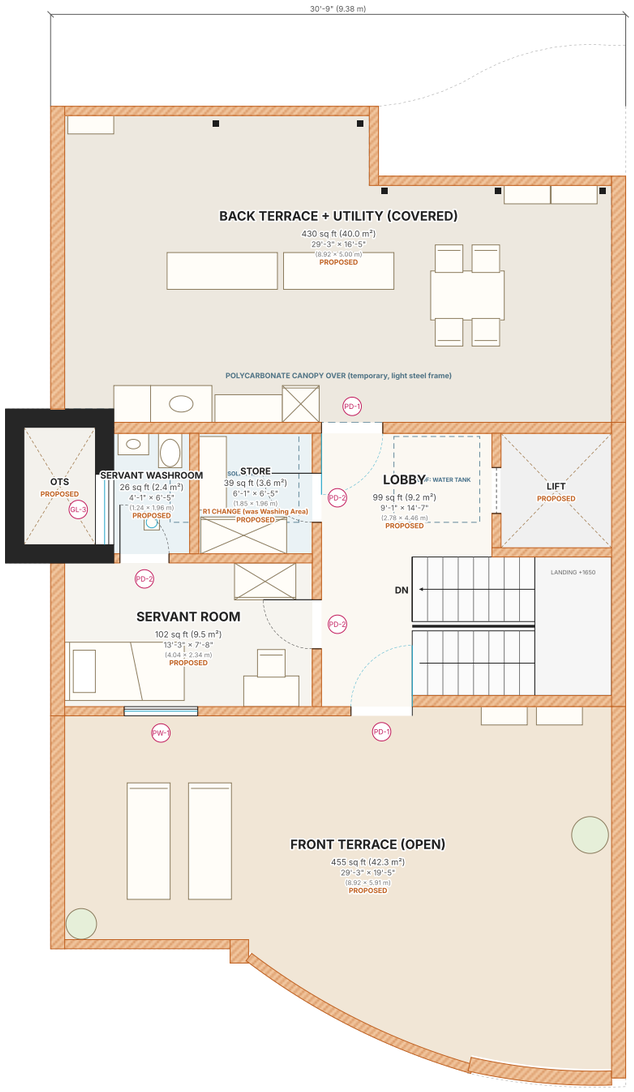

PROJECT :- RENOVATION WORK AT GH-18, CELEBRITY HOMES, PALAM VIHAR GURUGRAM
CLIENT:- **Mr. Praveen Kumar Yadav**
ARCHITECTS:- **Mr. Harish**

SHEET CONTENTS :- **GROUND FLOOR PLAN & FIRST FLOOR PLAN**

| DRN. | CHD. | DWG. NO. :- |
|---|---|---|
| | | UPS/GH18/PV/001 |

RELEASED FOR :- ☐ PRELIMINARY ☐ TENDER ☐ INFORMATION ■ APPROVAL ☐ FABRICATION ☐ SERVE

DATE :- **26.10.26**
SCALE:- **1:100 (A3)**
REV. **R1**
SHT.NO. **1 of 2**




## SECOND FLOOR PLAN (PROPOSED)

SCALE 1:100 (A3)

FFL +23'-2" (7.05 m) · floor to floor 10'-10" (3.30 m)

### LEGEND

- Existing wall
- Proposed wall (SF)
- Glass / glazing
- Door / window mark (see schedule)
- New wall / partition
- Boundary wall 1500 high
- Floor above / overhead (dashed)
- R1 CHANGE — room changed from R0

N

road side

GRAPHIC SCALE 1:100

0 — 5 m

0 — 16 ft

## DOOR-WINDOW SCHEDULE · SF

| MARK | SIZE | CILL | LINTEL | NOS | DESCRIPTION | LOCATION |
|---|---|---|---|---|---|---|
| GL-3 | 3'-9" × 4'-9" (1.15 × 1.45 m) | 3'-1" (0.95 m) | 7'-10" (2.40 m) | 1 | Glass Window Openable | SF Servant Washroom |
| PD-1 | 3'-3" × 7'-10" (1.00 × 2.40 m) | — | 7'-10" (2.40 m) | 2 | Glazed door to terrace | SF Back Terrace + Utility (covered), Front Terrace (open) |
| PW-1 | 3'-11" × 4'-9" (1.20 × 1.45 m) | 3'-1" (0.95 m) | 7'-10" (2.40 m) | 1 | Glass Window Openable | SF Servant Room |
| PD-2 | 2'-7" × 7'-10" (0.80 × 2.40 m) | — | 7'-10" (2.40 m) | 3 | Flush Door | SF Servant Room, Servant Washroom / Servant Room, Store |
| D4 | As Lift | — | — | 1 | As Lift, as per lift vendor | SF Lift / Lobby |

## R1 REVISION NOTES (CHANGES FROM R0)

| REF | AREA | CHANGE |
|---|---|---|
| A1, A2 | General | North is the road side (all consultant drawings). Dimensions in feet-inches with metres in brackets. |
| B3 | GF Family Lounge | Drawing room becomes a family lounge: TV and AC on the west wall, L-sofa facing the TV. |
| B6 | GF Family Lounge | Small open mandir on the east wall at the NE corner; devotee faces east; no toilet behind or above. |
| D-01 | GF Kitchen / Dining | Closed kitchen on the R0 peninsula line with sliding door KD-1; dining moved beside the lobby. |
| B4 | GF Kitchen | No construction outside: GL-4 back at its R0 position; wash nook (double sink) inside, vent KW-1 into the OTS. |
| B5 | GF Study | Becomes Guest Lounge / Study: desk on the east wall, sofa, settee, TV. |
| B7 | GF Panel & Janitor | Becomes under-stair storage with inverter / network rack; DB-1 moves to the kitchen east wall (SE). |
| B15 | GF Back lawn | Deck and pergola outside GL-5; tulsi vrindavan in the lawn's NE corner on the boundary wall. |
| C10 | FF Master suite | Washroom and dresser swapped (bedroom → dresser → washroom); bath tub with over-tub screen; vent KW-2. |
| D-04, C9 | FF Bedrooms | Front-left room is Bedroom 3, front-right is the Kids Room; kids toilet back at its R0 place. |
| C8 | FF Lobby | Cupboard by the lift becomes a pantry counter with wall cupboards, 10" clear of the lift door. |
| D11 | SF (proposed) | Lobby, servant room + washroom, store; open utility and drying on the covered back terrace. |
| E12, E13 | Services | Plumbing and electrical layouts Rev A re-applied to this layout (separate drawings and reports). |
| F16 | Materials | Floors: Italian marble (Option A) or 1600 × 800 tiles (Option B), owner to decide; counters black granite. |

## GENERAL NOTES

| NO | NOTE |
|---|---|
| 1 | All dimensions in feet-inches with metres in brackets. Do not scale; check on site. |
| 2 | Drawn from the R1 model (house_r1.json). Every R0 dimension is re-measured (plans/r1/check_report.txt). |
| 3 | The second floor is a proposal; it is not on R0. Structure, lift overrun and tank stand to be confirmed. |
| 4 | Read with the R1 change register, the plumbing and electrical reports and the materials schedule. |

## FINISHING SCHEDULE · SF

| LOCATION | FLOOR | WALL | CEILING | REMARKS |
|---|---|---|---|---|
| SF Lobby | Italian Stone* | Paint Finish | POP Painted | |
| SF Servant Washroom | Tile (matte 1200×600) | Tile | POP Painted | |
| SF Store | Tile (matte 1200×600) | Tile | POP Painted | was Washing Area. Linen / utility store (D11) |
| SF Servant Room | Vitrified tile 600×600 | Paint Finish | POP Painted | |
| SF Back Terrace + Utility (covered) | Deck tile (wood-look, anti-skid) | Paint Finish | Polycarbonate canopy | Washer-dryer, sink, ironing, drying racks (D11) |
| SF Front Terrace (open) | Deck tile (wood-look, anti-skid) | Paint Finish (parapet) | — (open) | |

## OPEN ITEMS & HOLD POINTS

| ITEM | FOR |
|---|---|
| Master washroom over the kitchen: sunken floor, waterproofing, flood test | Architect, structural, plumber |
| Front curved balcony (red-line 16): kids-room glazing forms the curve | Architect |
| GF toilet vanity at the south end (R0 position kept) | Architect |
| Tank stand on the SF roof, OTS opening, lift pit and overrun | Structural, lift vendor |
| Deck pergola under "no outside construction" | Owner |
| Living / bedroom floors: Option A marble or Option B tiles | Owner |
| Tulsi in the plot's SE zone; guest-room AC unit in the NE; DB-3 in the E zone | Vastu consultant |
| Master headboard on the W wall (red-line asks S); SF rooms not in the S / SW | Vastu consultant |
| Sewer invert levels and the municipal connection | Plumber, RWA / MCG |

## ROOM AREAS (internal, incl. built-in joinery)

| FLR | ROOM | SQ FT | M² |
|---|---|---|---|
| GF | Kitchen | 171 | 15.9 |
| GF | Dining | 149 | 13.8 |
| GF | Family Lounge | 179 | 16.6 |
| GF | Lobby | 137 | 12.7 |
| GF | Toilet | 90 | 8.4 |
| GF | Guest Room | 202 | 18.7 |
| GF | Entrance Foyer | 60 | 5.6 |
| GF | Guest Lounge / Study | 147 | 13.6 |
| GF | Under-stair Storage | 51 | 4.7 |
| GF | Total indoor | 1185 | 110.1 |
| FF | Master Washroom | 55 | 5.1 |
| FF | Dresser | 87 | 8.1 |
| FF | Master Bedroom | 275 | 25.6 |
| FF | Balcony (outdoor) | 68 | 6.3 |
| FF | Bedroom 3 Toilet | 68 | 6.4 |
| FF | Lobby | 99 | 9.2 |
| FF | Bedroom 3 | 273 | 25.4 |
| FF | Kids Room | 227 | 21.0 |
| FF | Kids Toilet | 50 | 4.7 |
| FF | Total indoor | 1135 | 105.5 |
| SF | Lobby | 99 | 9.2 |
| SF | Servant Washroom | 26 | 2.4 |
| SF | Store | 39 | 3.6 |
| SF | Servant Room | 102 | 9.5 |
| SF | Back Terrace + Utility (covered) (outdoor) | 430 | 40.0 |
| SF | Front Terrace (open) (outdoor) | 455 | 42.3 |
| SF | Total indoor | 266 | 24.7 |


CONTRACTOR:-

UNIQUE PROJECT SOLUTIONS

D-53/4, Ground Floor, Shaheen Bagh, Abul Fazal Encl.-2
Jamia Nagar, Okhla, New Delhi 110025
E- uniqueprojectsolutions@gmail.com
M-9911012341


PROJECT :- RENOVATION WORK AT GH-18, CELEBRITY HOMES, PALAM VIHAR GURUGRAM

CLIENT:- **Mr. Praveen Kumar Yadav**

ARCHITECTS:- **Mr. Harish**

SHEET CONTENTS :- **SECOND FLOOR PLAN (PROPOSED) & R1 NOTES**

DRN. | CHD. | DWG. NO. :- **UPS/GH18/PV/001**

RELEASED FOR :- ☐ PRELIMINARY ☐ TENDER ☐ INFORMATION ■ APPROVAL ☐ FABRICATION ☐ SERVE

DATE :- **26.10.26**

SCALE:- **1:100 (A3)**

REV. **R1** | SHT.NO. **2 of 2**